


THIS DRAWING IS COPYRIGHT

COMPUTERISED INFORMATION IS NOT TO BE ADDED TO OR ALTERED WITHOUT THE EXPRESS PERMISSION OF JS+P ARCHITECTURE

REV B 23.03.11 AF - Red line adjusted inline with previous application.

Rev C 28.03.11 AF - Title block notation amended
Rev D 09.05.11 AF - Building footprint amended to sit within site boundary

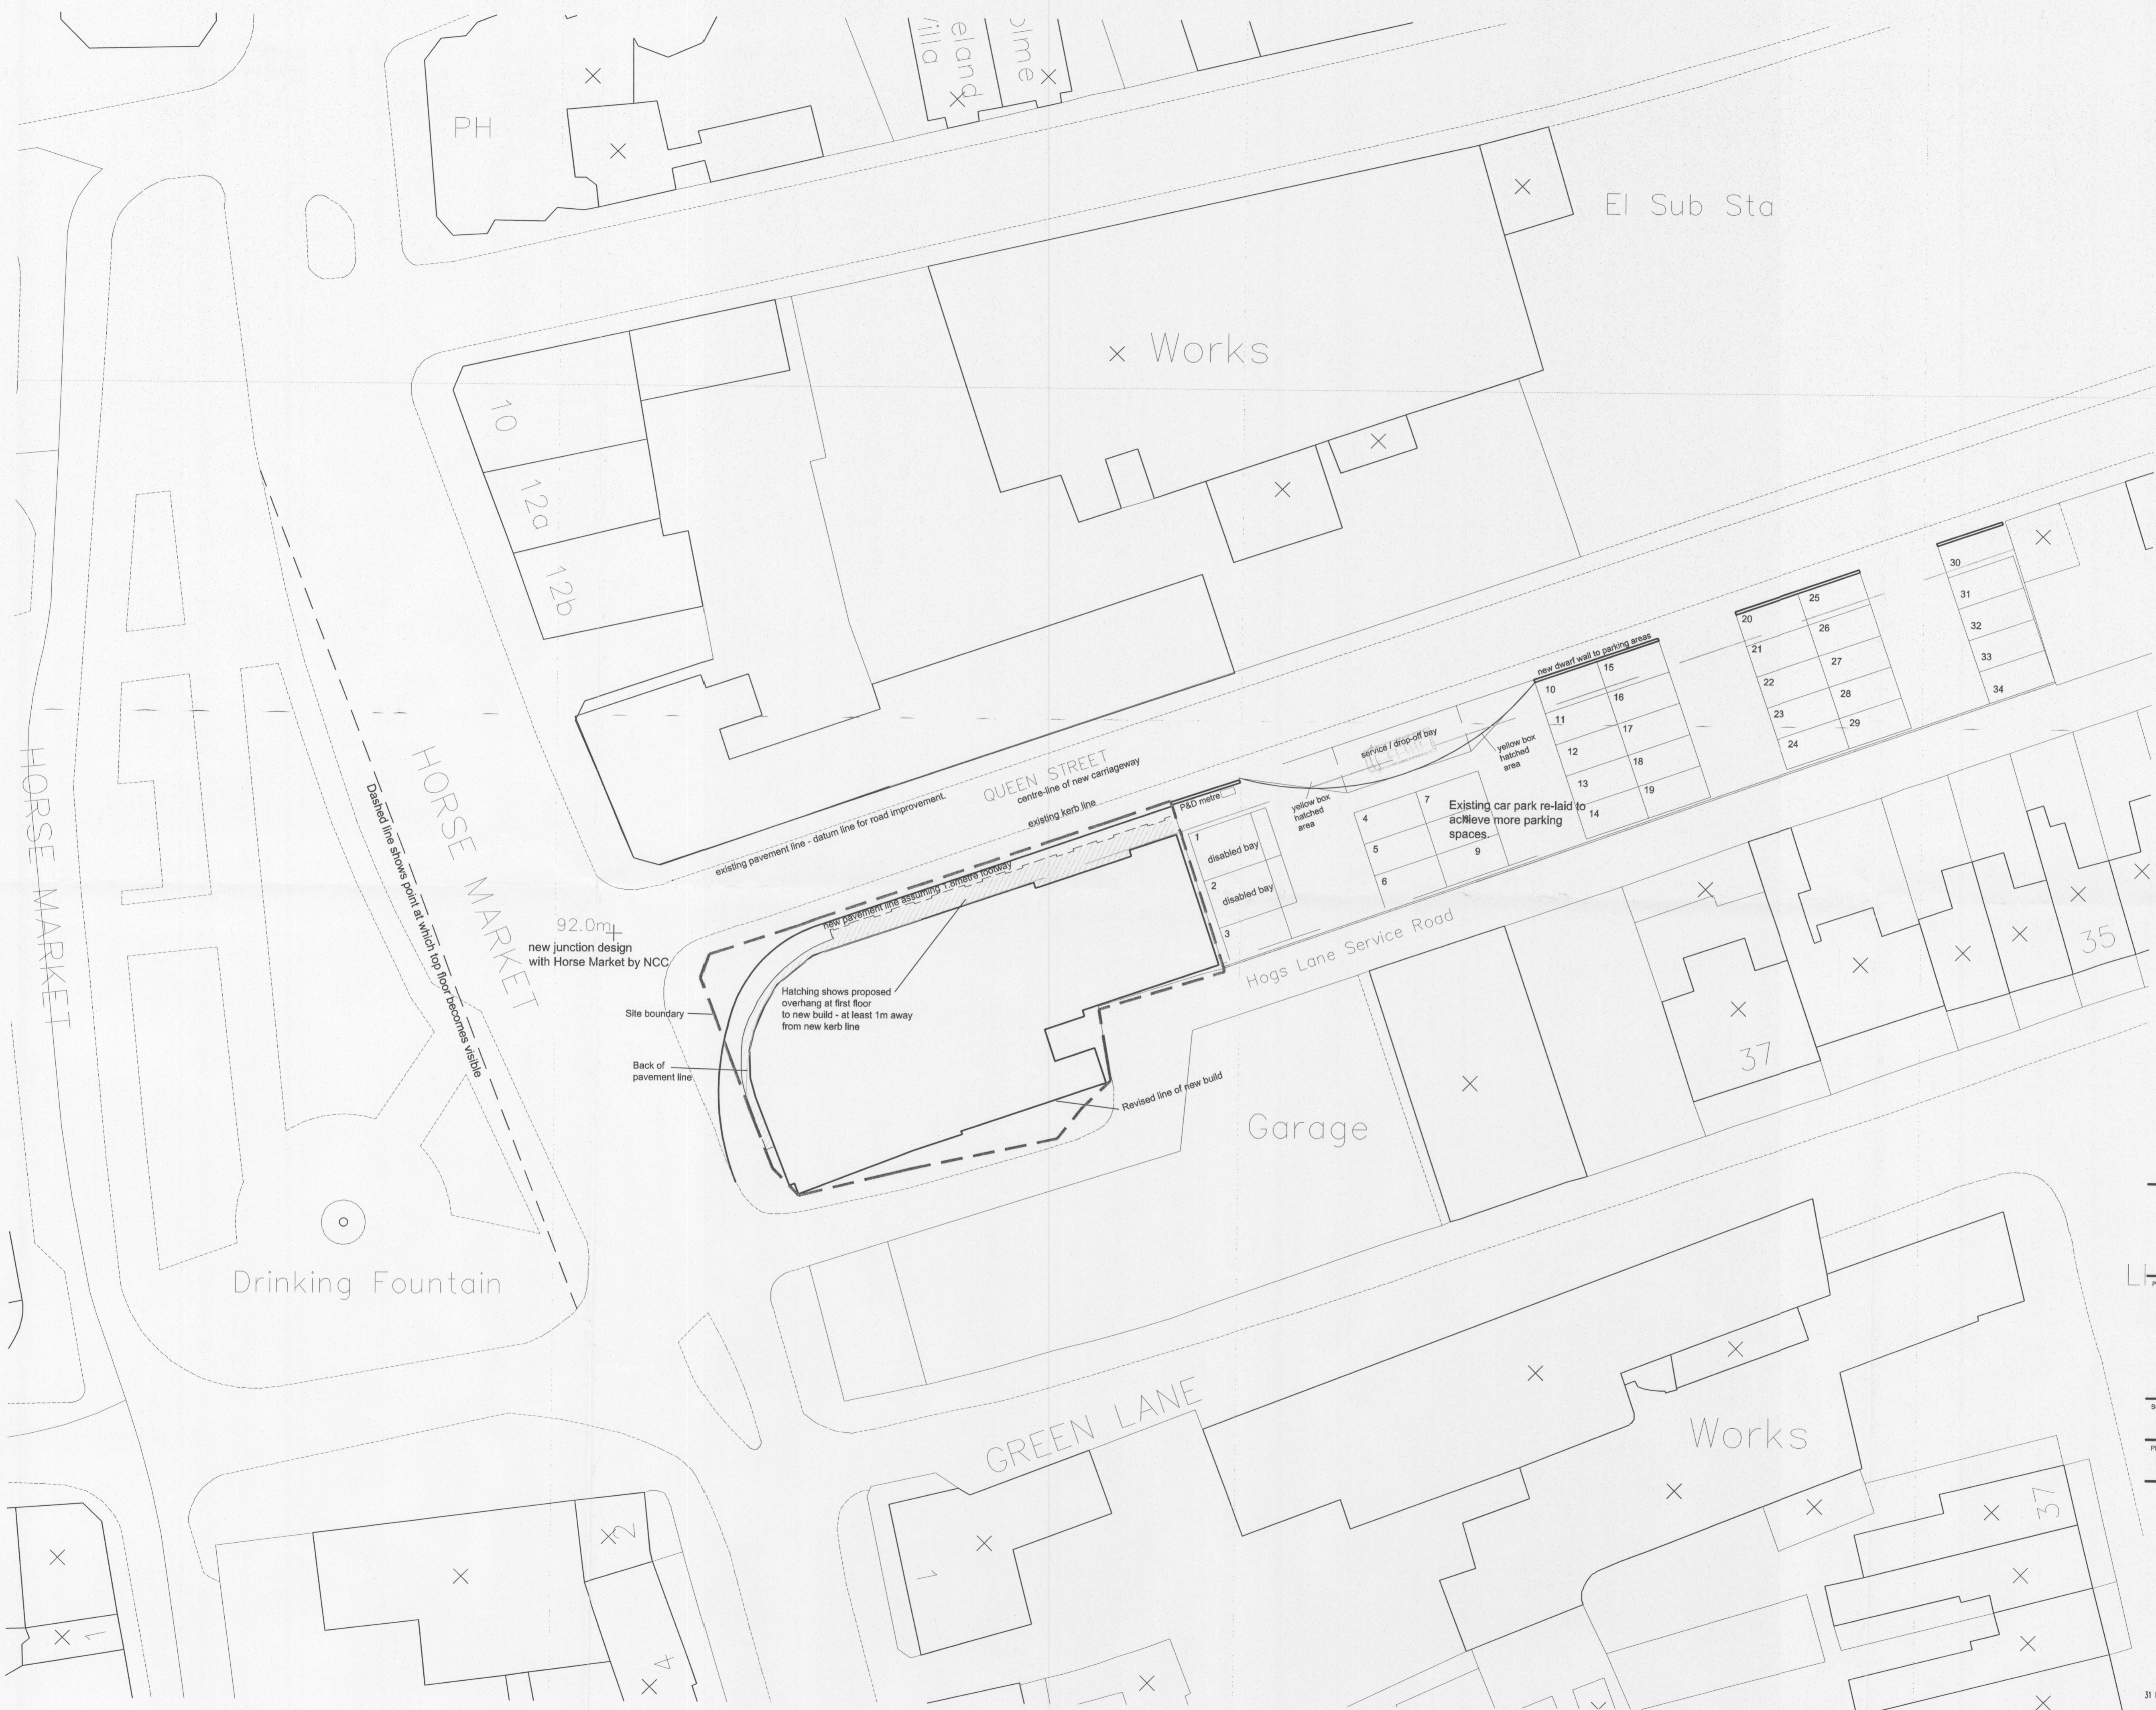


Planning

PROJECT AND DRAWING TITLE
Proposed Development
Tykes Investments

Horse Market, Kettering
Site Plan

SCALE	DRAWN	DATE
1:250@A1	NCW	Nov 2007
PROJECT No.	DRAWING No.	REVISION
H043	00-004	D

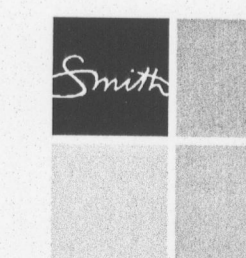

J S + P
ARCHITECTURE

31 Lower Brown Street Leicester LE1 5RH T +44 (0)116 247 0101 F +44 (0)116 247 0051
E leipzig@jpsa.co.uk

